

MONUMENT RECORD

Corner ID: **CICr_U09**



Section Corner

Sections 11, 12, 13, & 14 T07N-R01W, 2nd P.M.
Clear Creek Township, Monroe County, Indiana

Section 11 T07N-R01W	Section 12 T07N-R01W
Section 14 T07N-R01W	Section 13 T07N-R01W

MONUMENT: Describe monument set or found (Include material type, scribing, distance above/below grade, dimensions.)
1" steel spike found flush, witnessed by a 4" x 5" unmarked limestone flush on the south side of the spike.

MONUMENT LOCATION SKETCH:

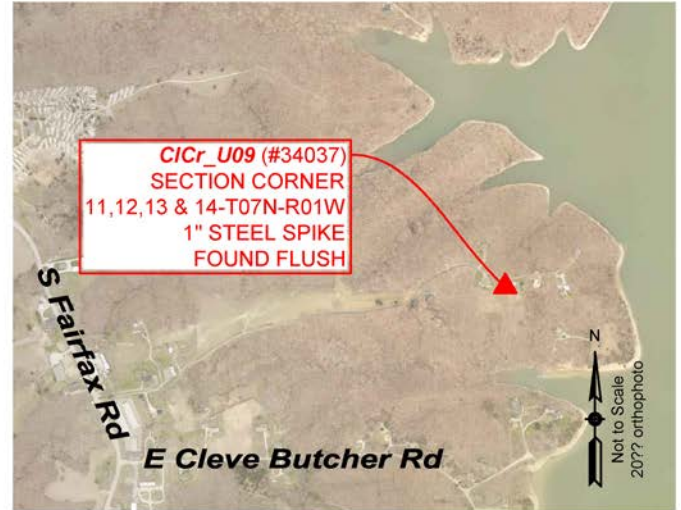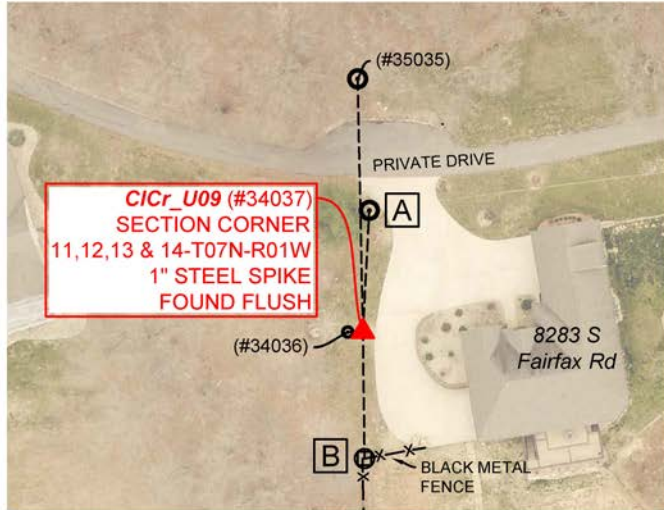

WITNESS MONUMENT TIES			
ID	BEARING	DISTANCE	DESCRIPTION
Witness A	N 3d E	50.6'	Mag nail found +/- 1.0' above grade on the east side of a utility pole
Witness B	S 1d E	52.7'	Northwest corner of a 2" x 2" black square metal decorative fence post
MONUMENT ACCESSORIES			
Other survey grade monuments that were located in the vicinity and their relation to the monument.			
(#34036)	S 87d30'42" W	6.24'	$\frac{3}{4}$ " iron pipe with plastic cap stamped "PRALL LS10234" found flush
(#35035)	N 1d11'45" W	105.11'	1 $\frac{1}{4}$ " iron pipe found 6" above grade on the south side of a t-post with lath marked "Lot Corner"



OFFICE OF THE MONROE COUNTY SURVEYOR • Trohn Enright-Randolph

119 W 7th Street, Bloomington, IN 47404 • 812-349-2570 • surveyoroffice@co.monroe.in.us

Page 1 of 3

MONUMENT RECORD

Corner ID: **CICr_U09**

Section Corner

Sections 11, 12, 13, & 14 T07N-R01W, 2nd P.M.
Clear Creek Township, Monroe County, Indiana

Section 11 T07N-R01W	Section 12 T07N-R01W
Section 14 T07N-R01W	Section 13 T07N-R01W

PHOTO IDENTIFIED: Photo Date: 04/10/2017



Photo Orientation & Description: CICr_U09 from above



Photo Orientation & Description: Looking east at CICr_U09



Photo Orientation & Description: Looking south at CICr_U09



Photo Orientation & Description: Looking north at CICr_U09

ORIGINAL OR SUBSEQUENT SURVEY EVIDENCE FOUND: Include, search area or areas, search procedure, etc.

Date of Field work/Search: 4/10/2017 By: RSO Monument Found: 1" steel spike BTs or Reference Objects Found: Iron pipe stamped "PRALL LS10234" and mag nail found on the east side of 10" utility pole found per current MCS tie sheet Project #: 34-T07N-R01W Field Book: 50/21 Equipment: The basis of bearings is Grid North System NAD83(2011)/Indiana West NAVD 88, Epoch 2010.0000, geoid12b_conus.db3, US Survey Feet, derived from GPS observations utilizing a Javad Triumph LS Rover and a Javad Triumph 2 Base. Static observations were post-processed using the JAVAD GNSS Data Online Processing Service (DPOS). Coordinate data was collected with a Javad Triumph LS Rover or radially with a conventional total station (Sokkia Set 510) from points established by GPS. Distances to witness ties were collected with a Leica Disto laser distance meter. Bearings to witness ties were collected with the internal magnetic compass of the Javad Triumph LS and were automatically adjusted to grid north and are approximately shown hereon for reference. Priority should be given to provide distances over bearings. Notes: The monument is witnessed by a 4" x 5" unmarked cut limestone found flush to the south

OTHER EVIDENCE: Describe corner location relative to nearby features and how to reach the corner location – note fences, roads, timber cutting lines, mow lines, clearings, plantings, streams, topo changes, etc.

The monument is on the west side of a concrete driveway and on the west side of a large clump of ornamental grass

MONUMENT PRESERVATION: Describe work done to preserve existing monument.

Took new ties, tied orange flagging around the monument



OFFICE OF THE MONROE COUNTY SURVEYOR • Trohn Enright-Randolph

119 W 7th Street, Bloomington, IN 47404 • 812-349-2570 • surveyoroffice@co.monroe.in.us

Page 2 of 3

MONUMENT RECORD

Corner ID: **CICr_U09**

Section Corner

Sections 11, 12, 13, & 14 T07N-R01W, 2nd P.M.
Clear Creek Township, Monroe County, Indiana

Section 11 T07N-R01W	Section 12 T07N-R01W
Section 14 T07N-R01W	Section 13 T07N-R01W

THEORY OF LOCATION: *Describe the theory of location for acceptance of this monument. Include monument origin and associated uncertainty.*
The 1" steel spike was previously witnessed and the Monument Record prepared under the direction of the Monroe County Surveyor, Kevin Enright, on March 02, 2000 and accepted by the Monroe County Surveyor Review Board on June 10, 2014. The 2014 Monument Record accepted the 1" steel spike per a Rober W. Brennemer survey, on file in the Surveyor Office RSID000973 and per a Will Sowders Road survey by Ben E. Bledsoe on file in the Recorder Office Instrument No. 2012006701.

CERTIFICATIONS:



Date:10/26/2020
Trohn Enright-Randolph
Monroe County Surveyor



Date:10/22/2020
Accepted by the Monroe
County Surveyor Review
Board



OFFICE OF THE MONROE COUNTY SURVEYOR • Trohn Enright-Randolph

119 W 7th Street, Bloomington, IN 47404 • 812-349-2570 • surveyoroffice@co.monroe.in.us

Page 3 of 3

MONUMENT RECORD
State of Indiana - County of Monroe

Section: 11

Township: 07 North

Range: 01 West

Corner ID: CICrU-09


Monument Description & Remarks: 1" daimeter solid Steel Spike.

Survey Sign not set

References On File: Rober W. Brennemer survey, US Gov'T line (1966) on file in Surveyor Office
Ben E. Bledsoe survey, Will Sowders Road (2010), on file in Recorder Office (IN2012006701)

RECOVERY TIE DRAWING

Field Book 32 Page No. 20

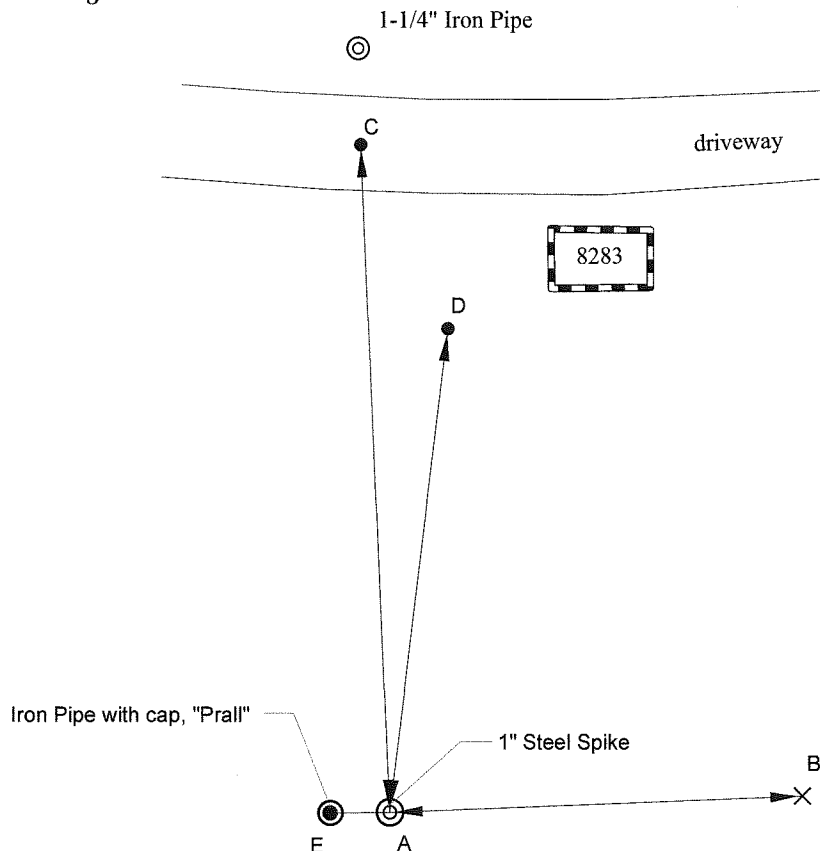

- A - 1" Steel Spike
- B - N 0° E 43.3' to corner of brick building
- C - N 2° W 69.52' to MAG nail in driveway
- D - N 7° E 50.68' to MAG nail in 10" power line pole
- E - N 90° W 6.27' to Iron Pipe with cap , "Prall"


Not To Scale
Compass Bearing Magnetic North

I, Kevin P. Enright, Monroe County Surveyor, hereby certify that this document was prepared under my direction in accordance with the provisions of section 36-2-12-11 of the Indiana Code; and the above data is given under my hand and seal this 2nd day of March, 2006.

Kevin P. Enright

Administered by the Monroe County Surveyor Review Board

6-10-2014

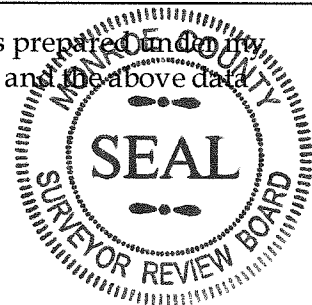

Drawn by: T.E.R. Entry date: May 10, 2013